




PRELIMINARY

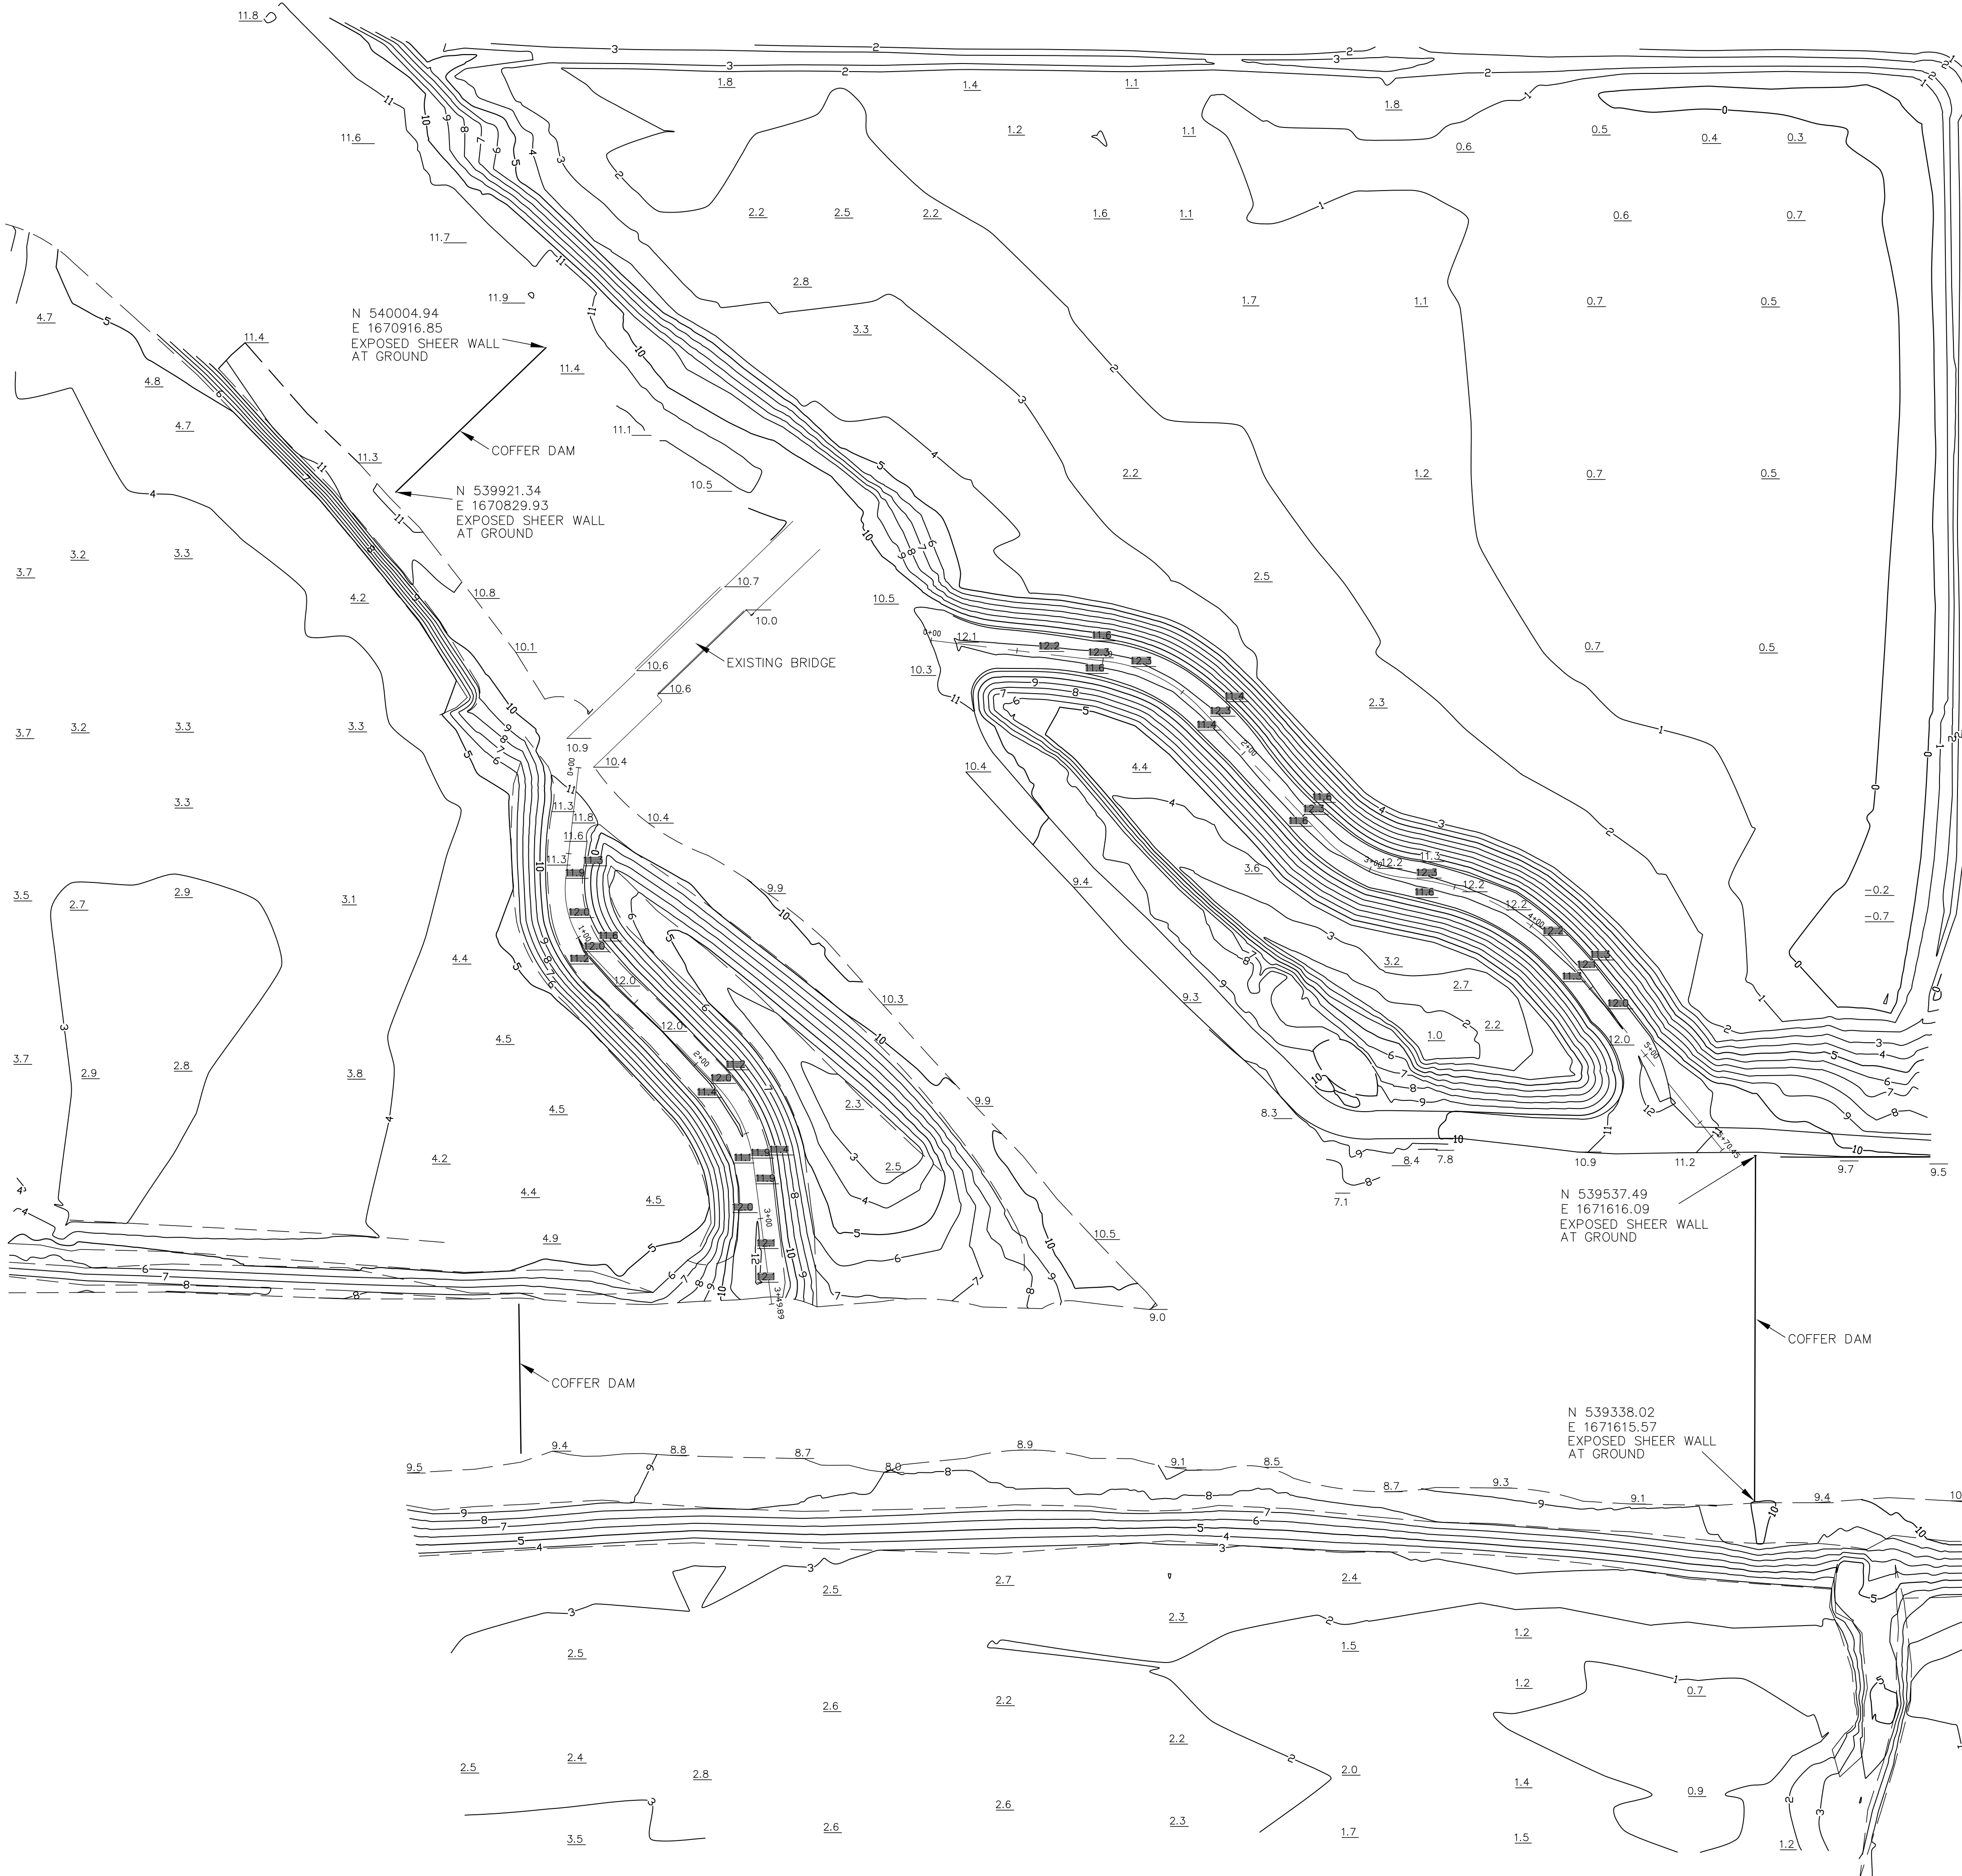

- LEGEND**
- 5' CONTOUR (5' INTERVAL)
 - 1' CONTOUR (1' INTERVAL)
 - COFFERDAM LOCATION
 - CONCRETE
 - GRADE BREAK/TOP/TOE
 - 1.1 SPOT ELEVATION

- NOTES:**
1. HORIZONTAL DATUM: BASED ON SURVEY CONTROL PER PROJECT DRAWINGS. NAD 27, ZONE 3.
 2. VERTICAL DATUM: BASED ON SURVEY CONTROL PER PROJECT DRAWINGS. (SEE BENCH MARK NOTE BELOW)
 3. INFORMATION SHOWN HEREON REPRESENTS CONDITIONS AT TIME OF SURVEY: DECEMBER 15, 2009 AND DECEMBER 21, 2009.

BENCHMARK:
ELEVATIONS SHOWN HEREON ARE BASED ON THE FOUND BUREAU OF RECLAMATION SURVEY DISK STAMPED "11.19". FOUND ON THE SOUTHEAST CORNER OF THE NORTHEAST ABUTMENT OF THE TRASH RACK LOCATED ON THE CONTRA COSTA CANAL, APPROXIMATELY 1.3 MILES SOUTHEAST OF THE INTERSECTION OF JERSEY ISLAND ROAD AND EAST CYPRESS ROAD. ELEVATION: 11.22 FEET (NGVD 29)

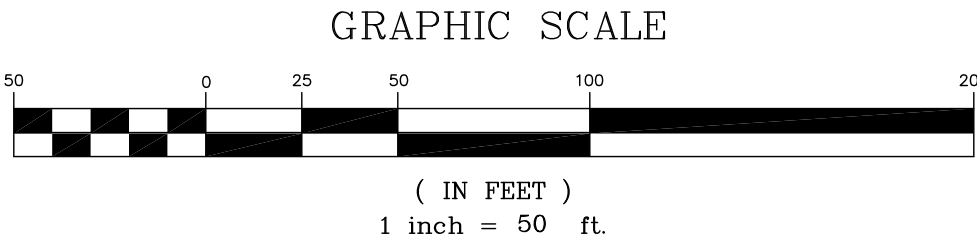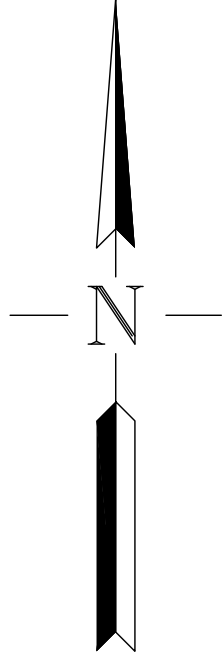

F3 & Associates, Inc.
Land Surveying
701 E.H ST BENICIA ,CA 94510
PHONE(707)748-4300 FAX(707)361-0295
www.F3-Inc.com

FISH SCREEN STRUCTURE PHASE 2 - LEVEES AND COFFERDAMS
AS-BUILT SURVEY EXHIBIT
CONTRA COSTA CANAL - PROJECT NO. 109065
BRENTWOOD CALIFORNIA CONTRA COSTA COUNTY

DESIGN BY:	NA
DRAWN BY:	STAFF
DATE:	MAR 2010
SCALE:	1"=50'
PAGE OF	1 1
JOB NUMBER:	9112